


NOTE:
CROSS-SECTION DIMENSIONS VARY
TO MEET FIELD CONDITIONS

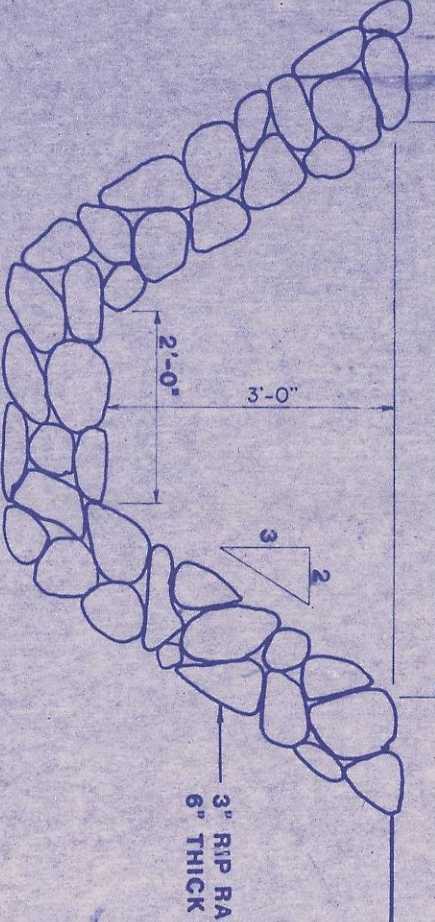

DRAINAGE DITCH CROSS SECTION
PROFILE IS SAME AS FINAL RECLAMATION (REF. CM-10318-WB)

ENGINEER'S CERTIFICATE

I, Whitney, Jr., hereby certify that I am a Registered Professional Engineer, licensed in the State of Utah, and that I hold Certificate No. 4904. I also certify that the design shown has been prepared under my general direction and review, and further, that it conforms to good engineering practice according to the best of my knowledge and belief.



DATE

NAME

NOTE: SEE DRAWINGS CM-10359-WB AND NS142E FOR CROSS SECTION DETAILS.

DATE	REVISIONS	BY	CHK.
2/11/80	ADDED OUTSLOPE AREA 130 ACRES	KAL	1/1/8
2/11/83	REVISED TO REFLECT AS-BUILT CONDITIONS AS BUILT SITES 1THRU 8 - ADDED BERM X-SECT.	KAL	1/1/8
5/1/84	REVISED DRAINAGE DITCH AS-BUILT	AWB	1/1/8
6-5-83	ADDED PROPOSED DISPOSAL SITES 3 THRU 8	SMC	CE-S
2-18-83	CHANGED EPHEMERAL DRAINAGE DIVERSION	SMC	CE-S
2-8-83	AS BUILT SITE # 1 & PROPOSED SITE # 2	SMC	CE-S

AS-BUILT CONDITION
I do hereby certify that I am a Registered Professional Engineer in the State of Utah, and do hereby certify that the design shown represents the actual condition of the Waste Storage Site Facility, to the best of my knowledge.

COTTONWOOD/WILBERG & DES-BEE-DOVE MINES
UNDERGROUND DEVELOPMENT
WASTE STORAGE SITE
UTAH POWER & LIGHT COMPANY
DEPARTMENT OF MINING & EXPLORATION
DRAWN BY: 4. STANDEBERG
CHECKED BY: CE-S
DRAWING NUMBER
CM-10361-WB

Appendix V
DIVISION OF
OIL, GAS & MINING

